
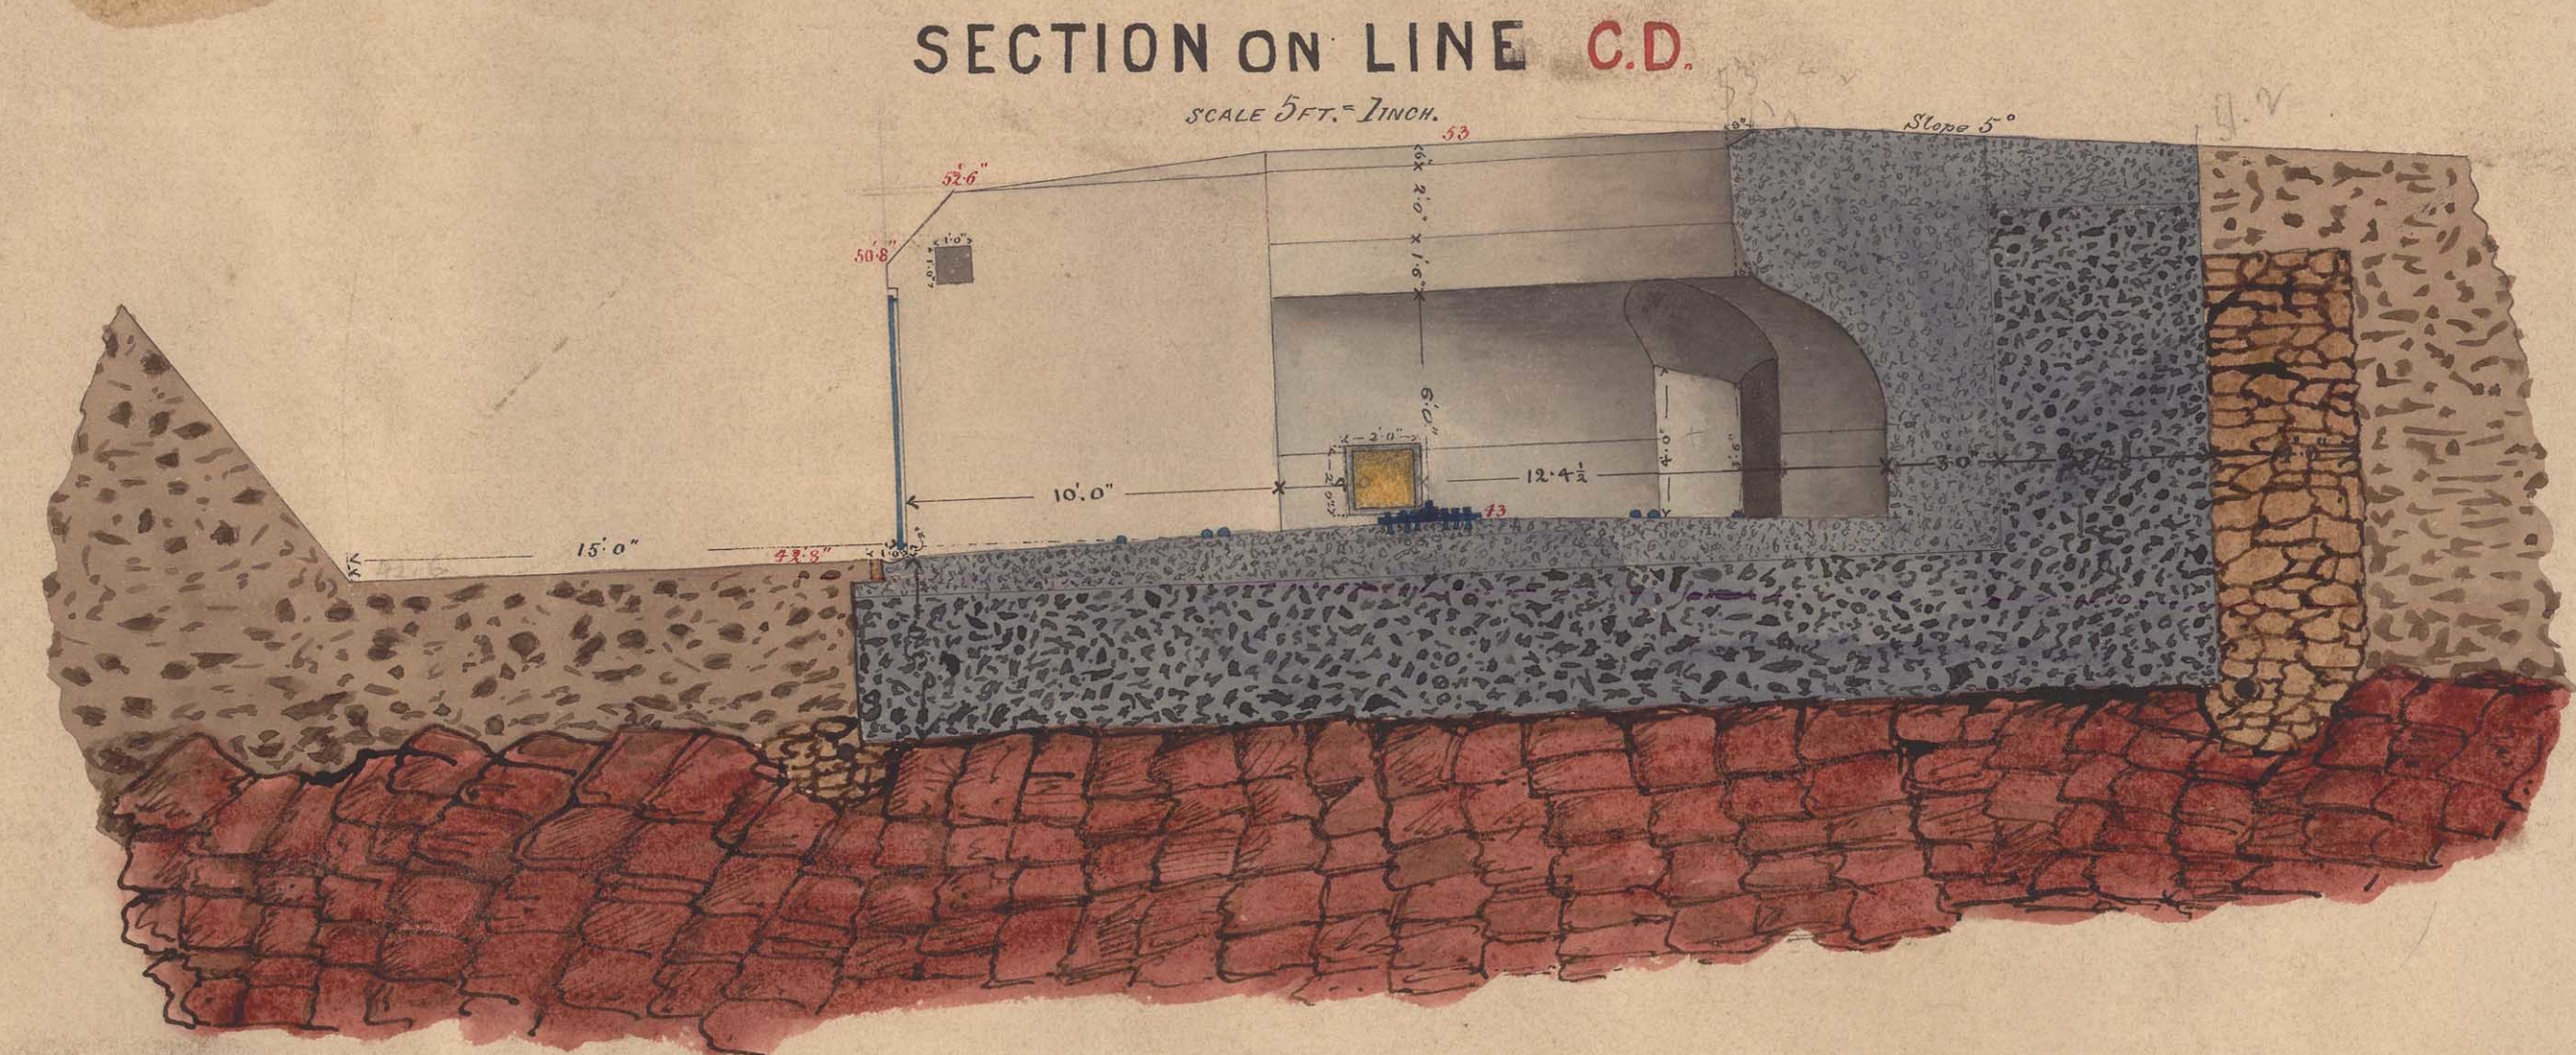


CAMDEN FORT - CORK HARBOUR

DRAWER II


RECORD PLAN OF LEFT LOWER BATTERY

FOR 3 7 INCH M.L. GUNS ON MONGRIEF PLATFORMS

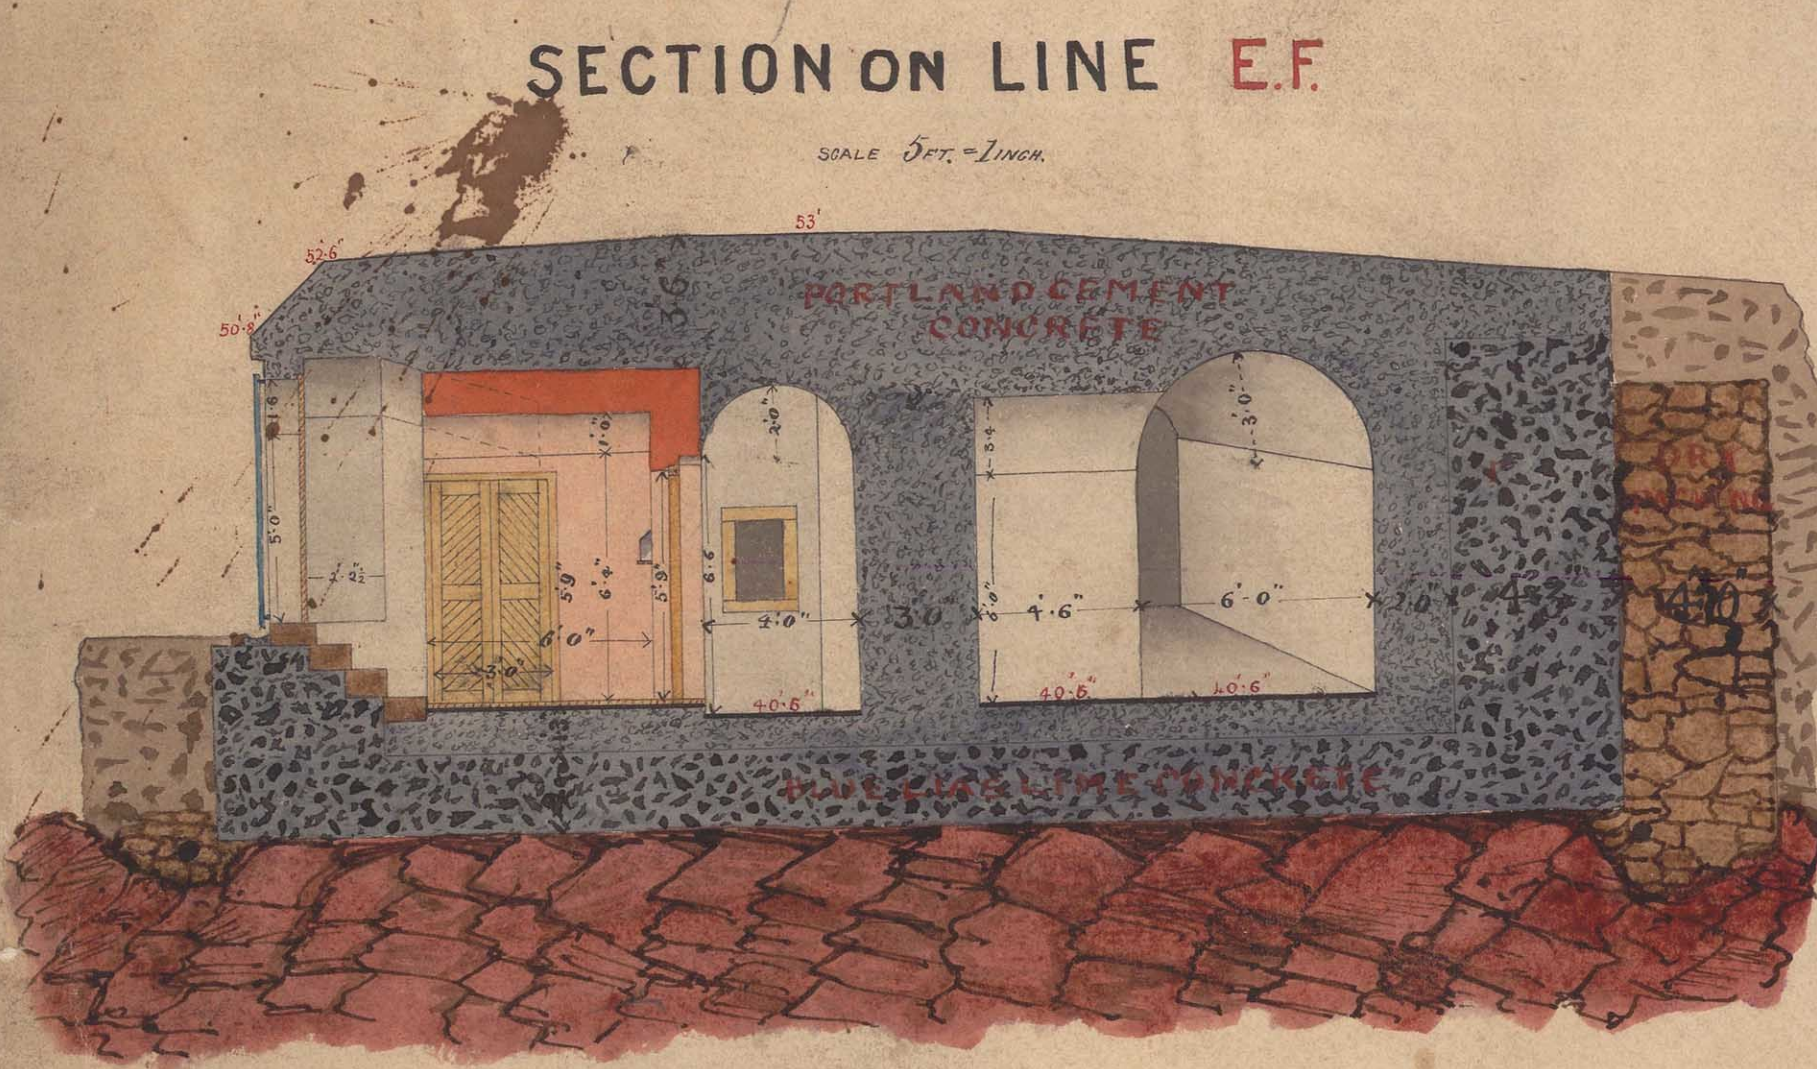


SITE PLAN

SCALE 50 FT. = 1 INCH

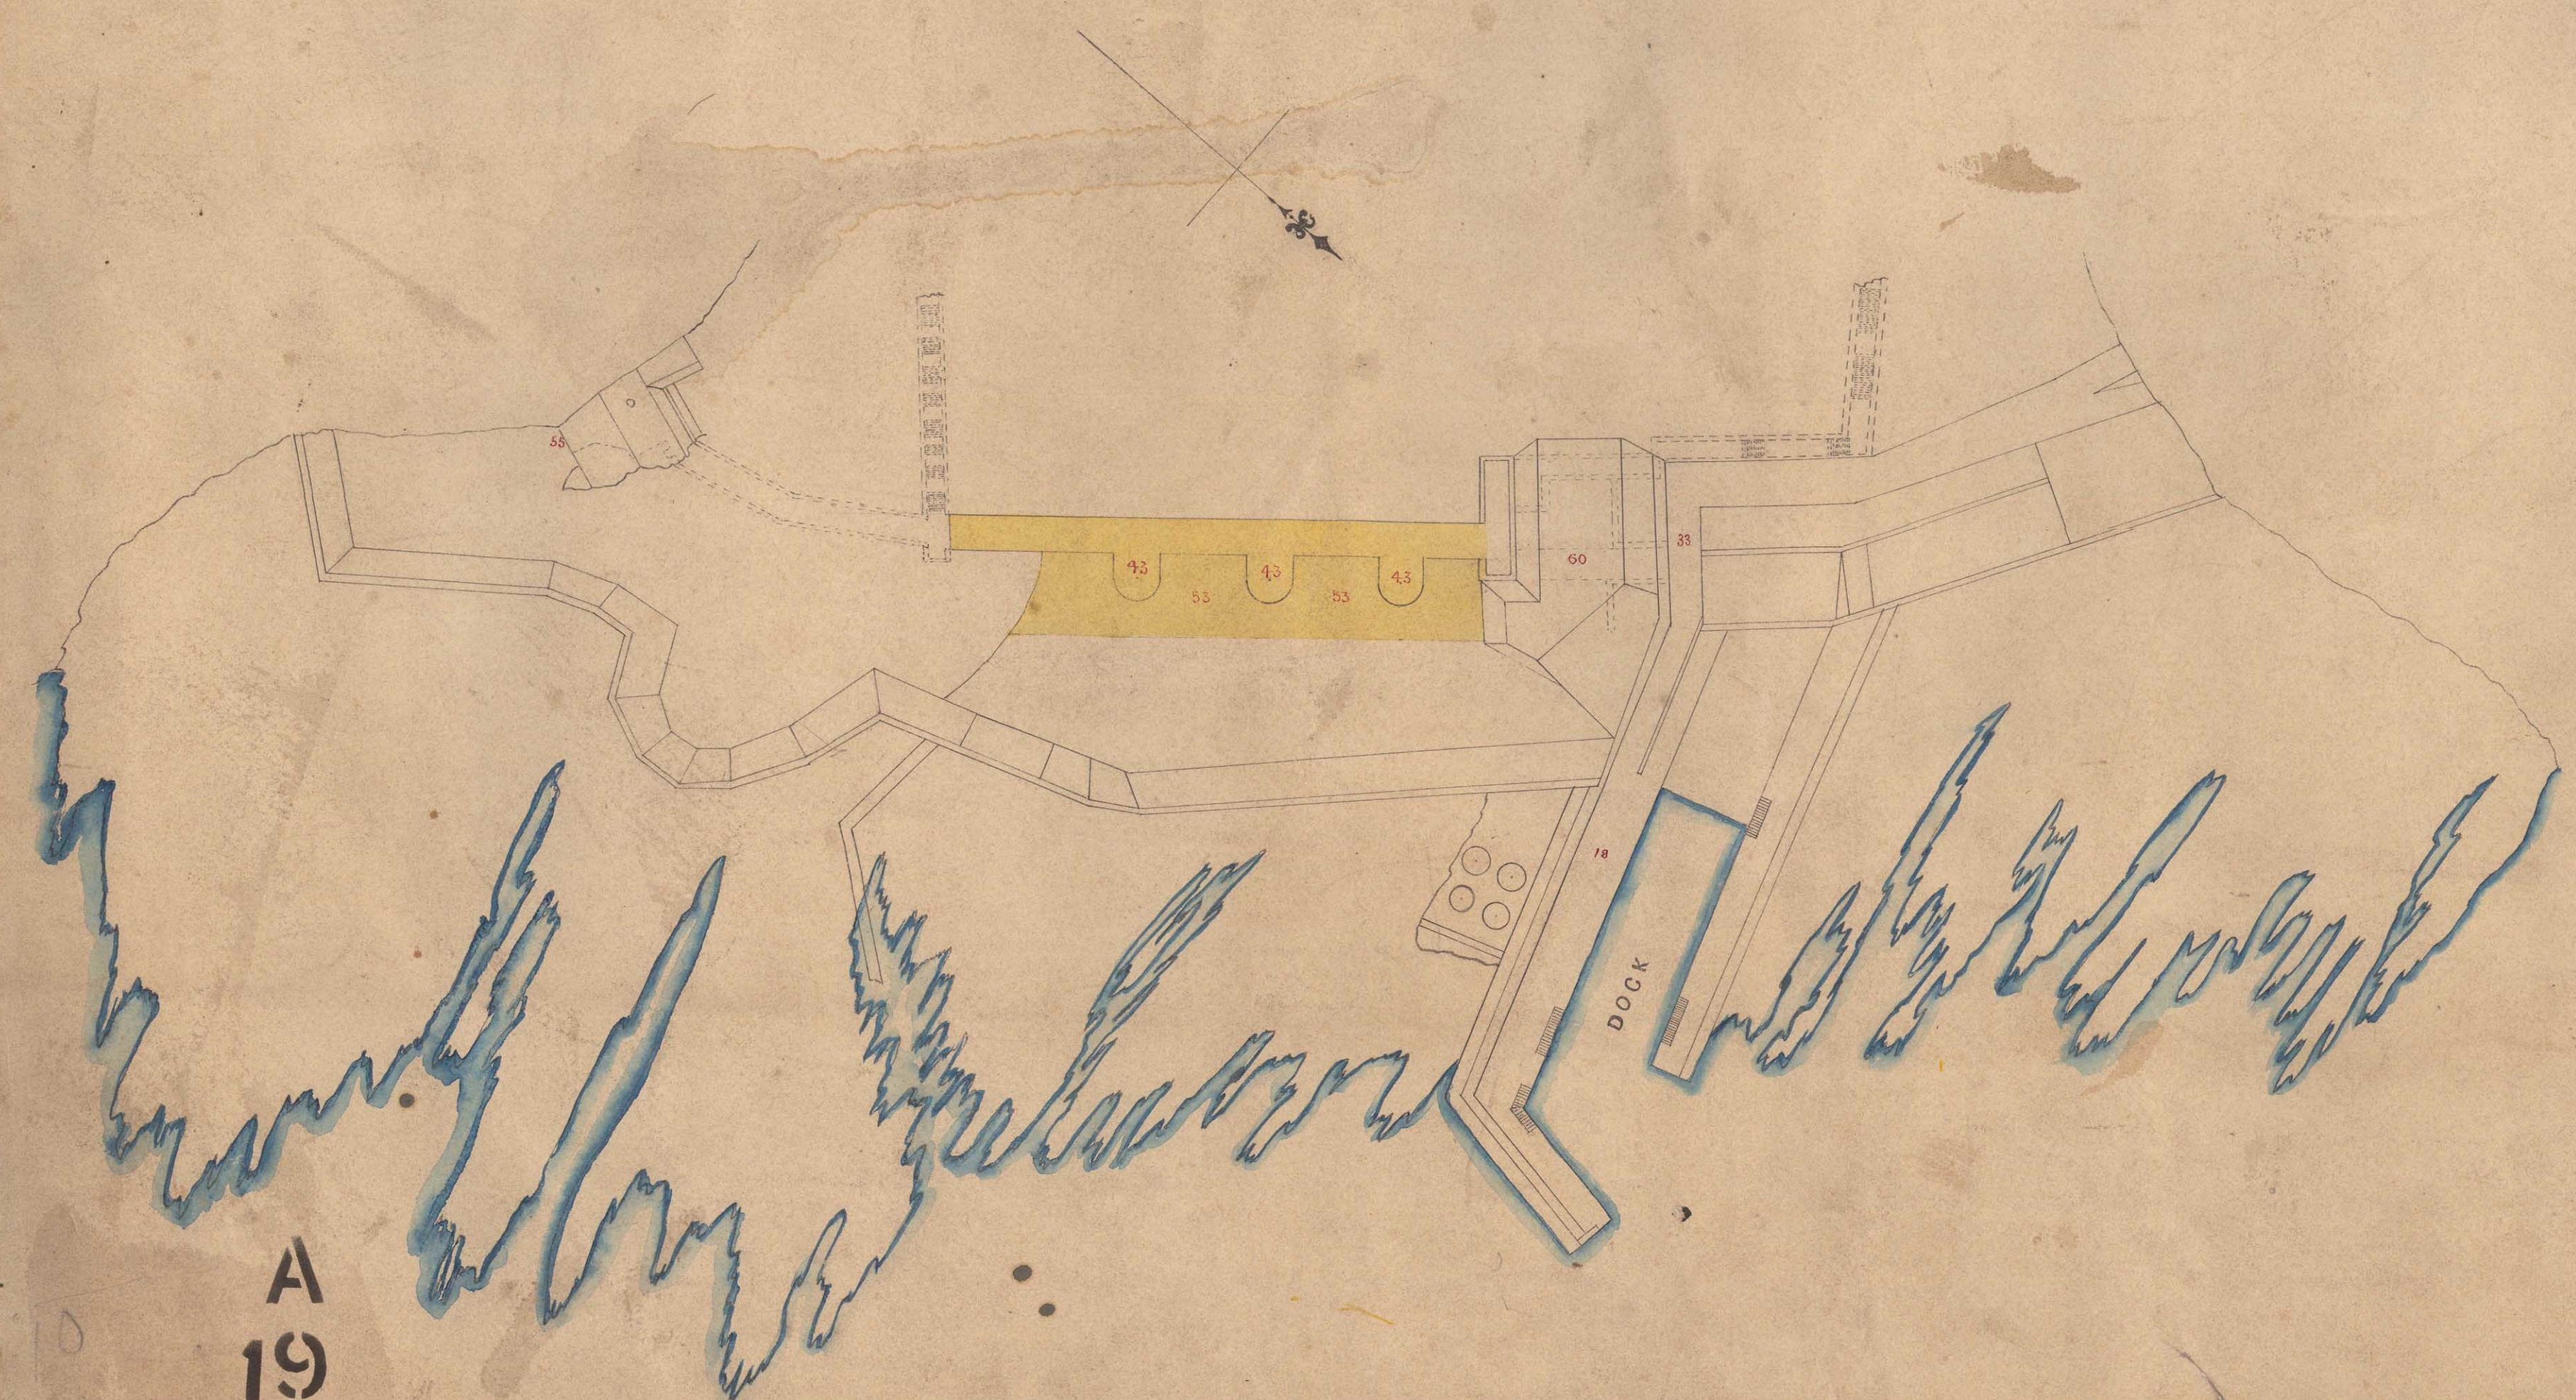


TOP PLAN

SCALE 10 FT. = 1 INCH

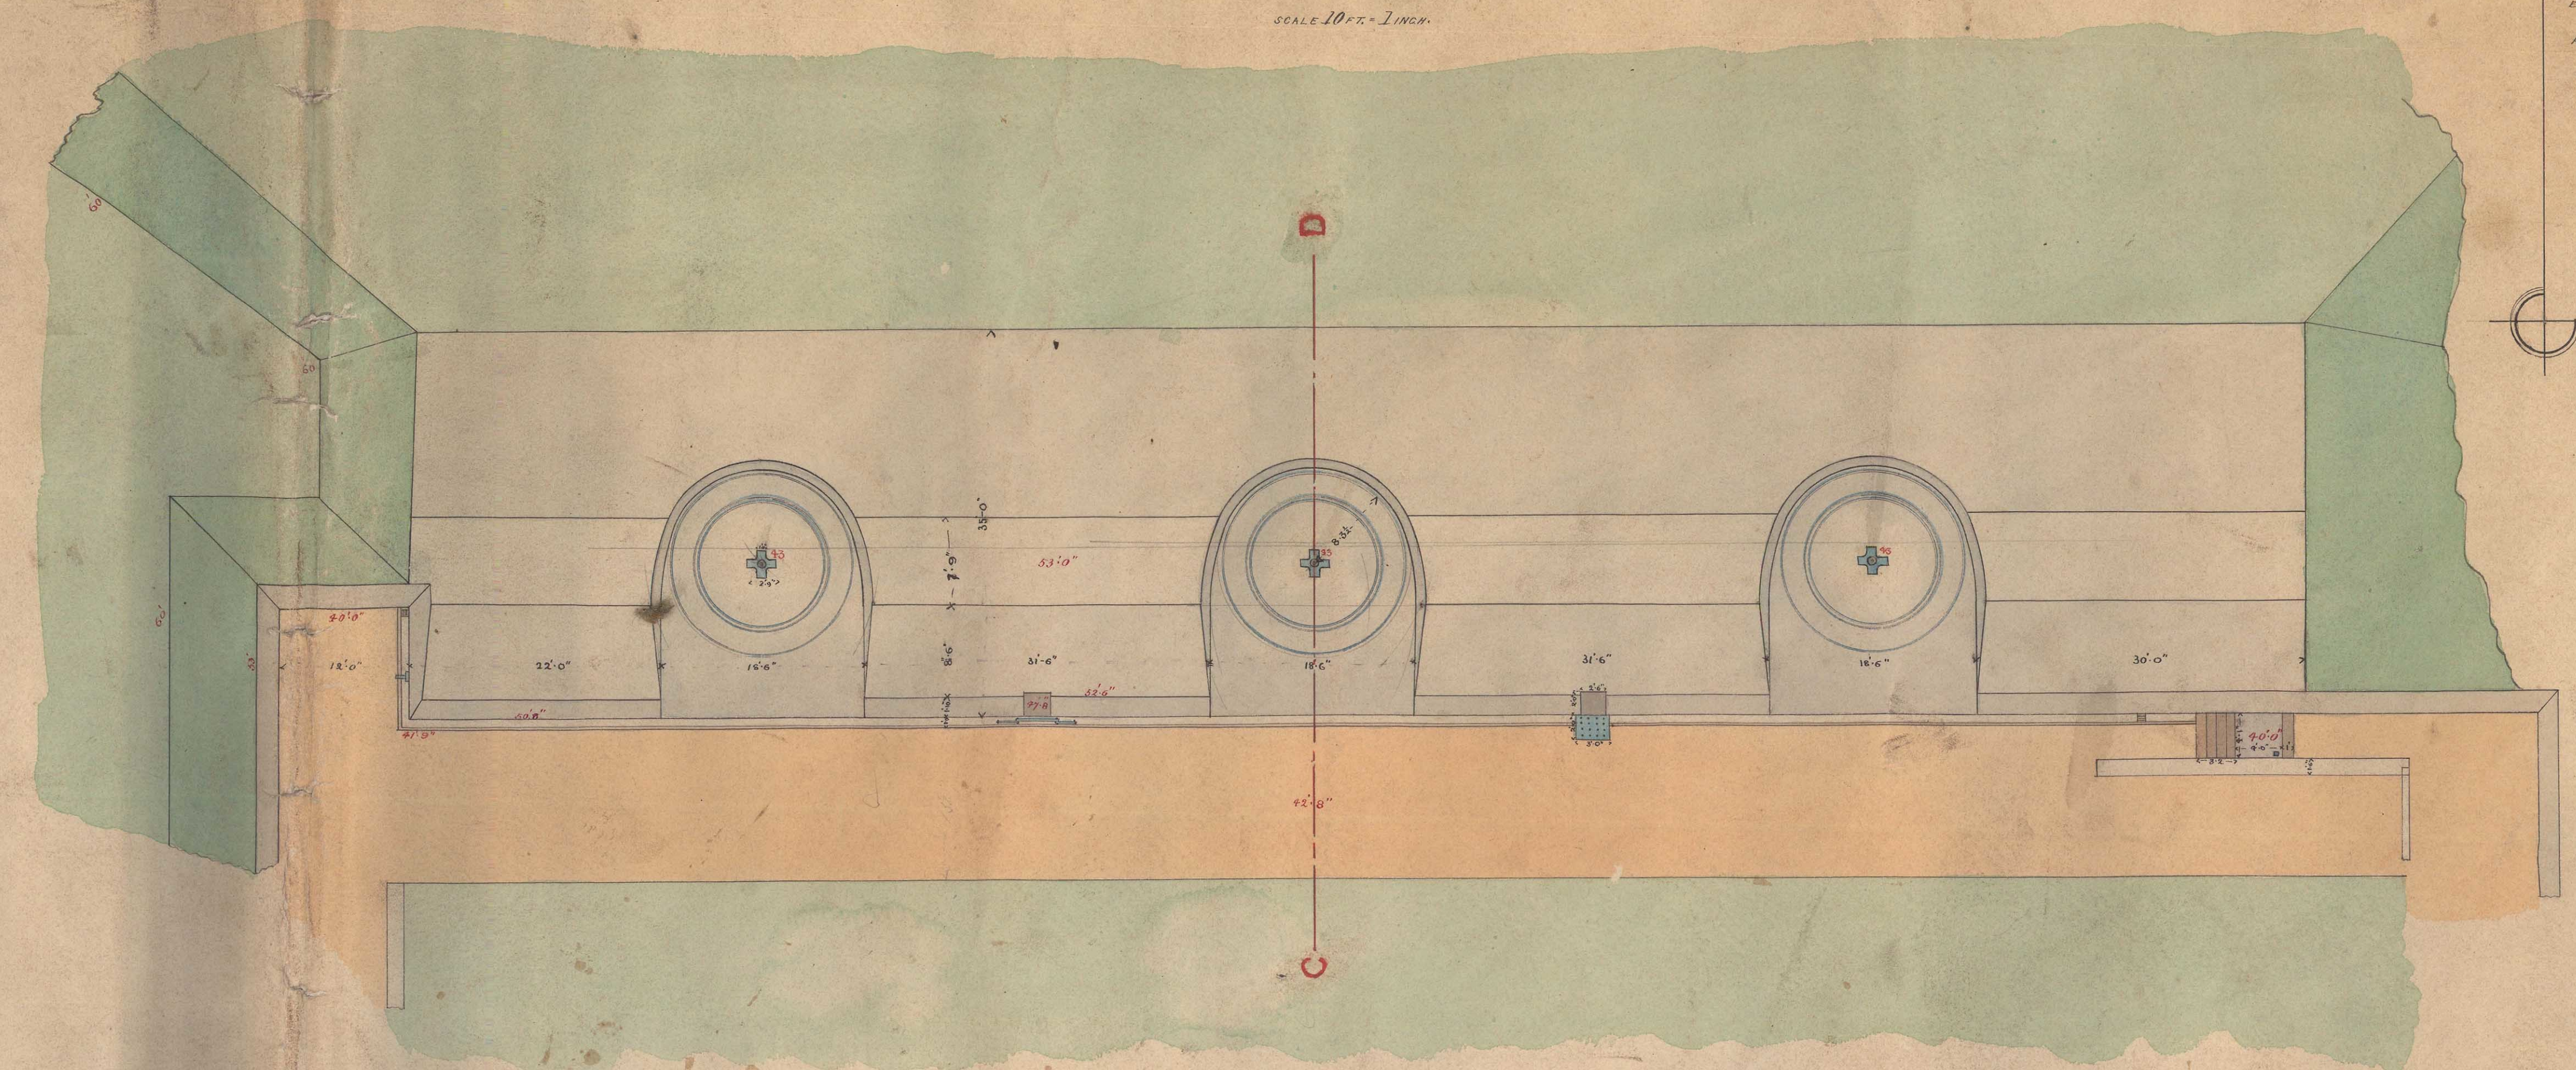


GROUND PLAN

SCALE 10 FT. = 1 INCH

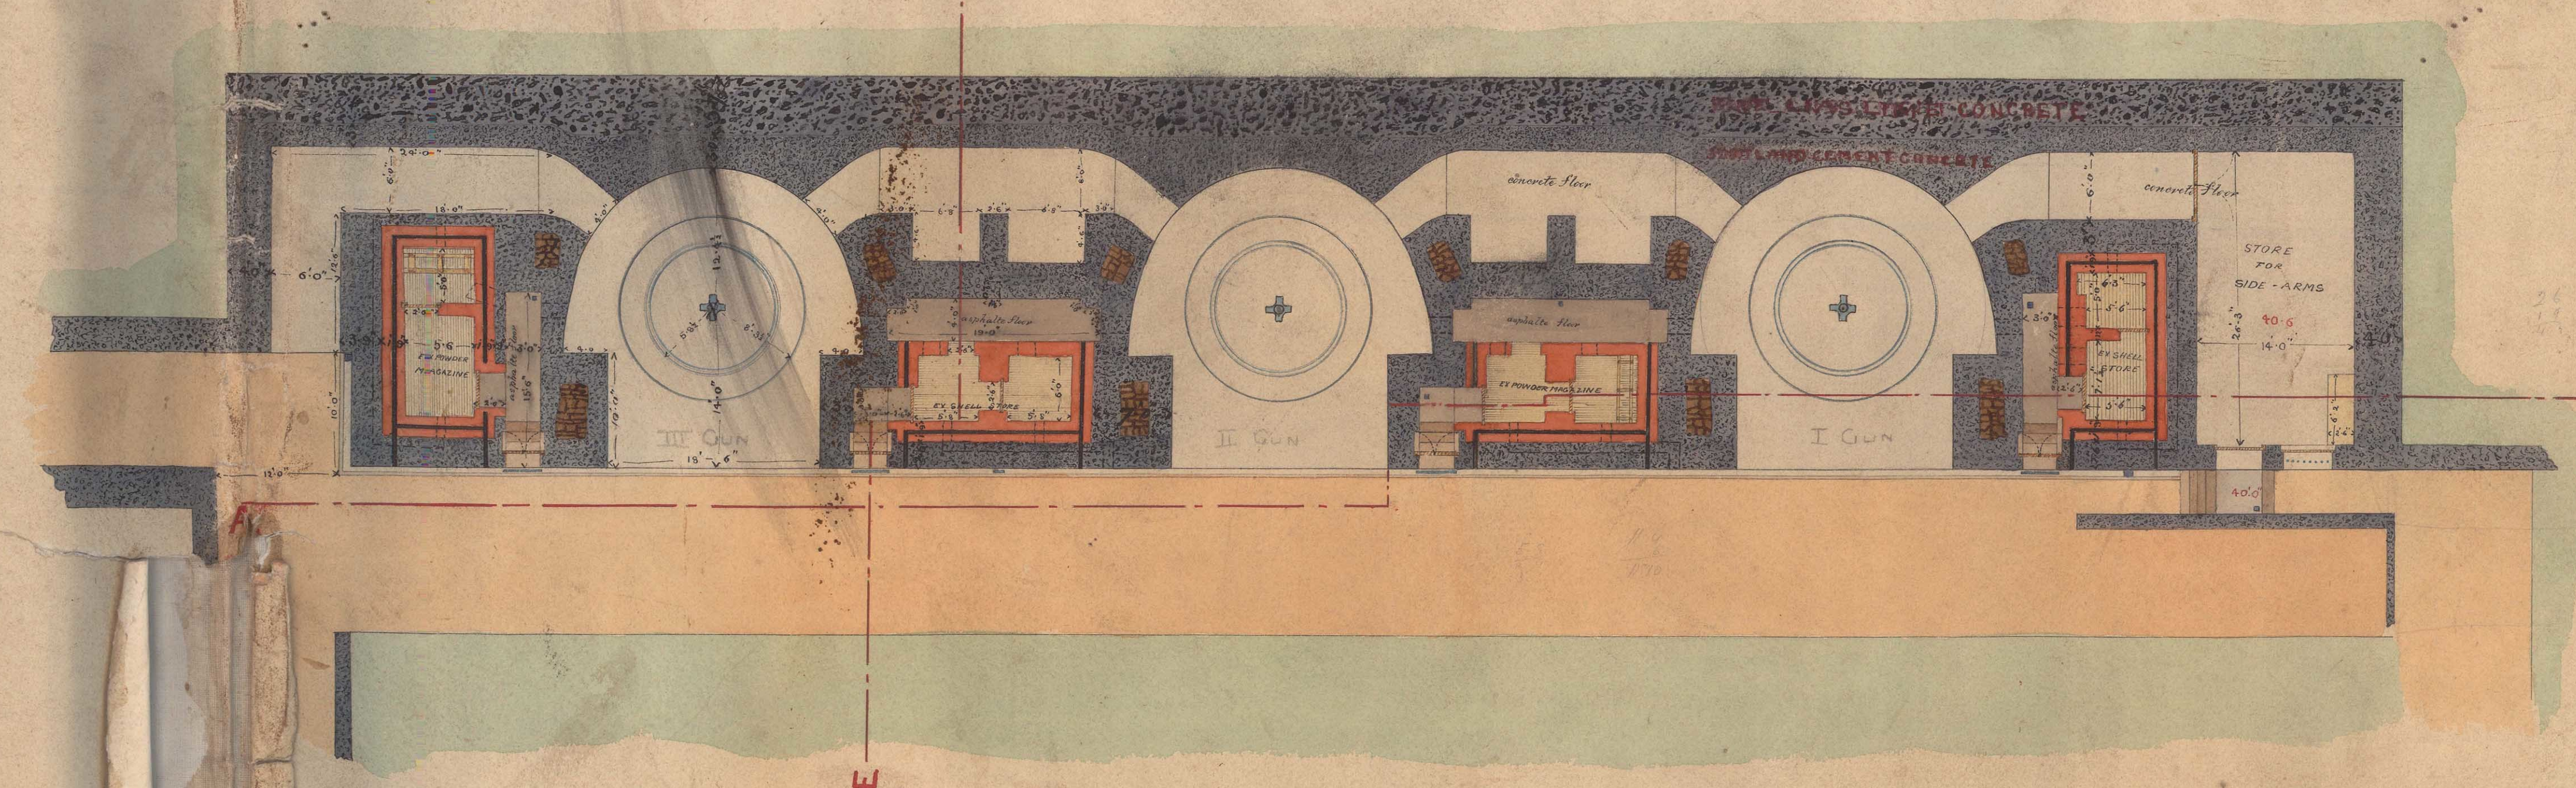

ELEVATION AND SECTION ON LINE AB

SCALE 10 FT. = 1 INCH

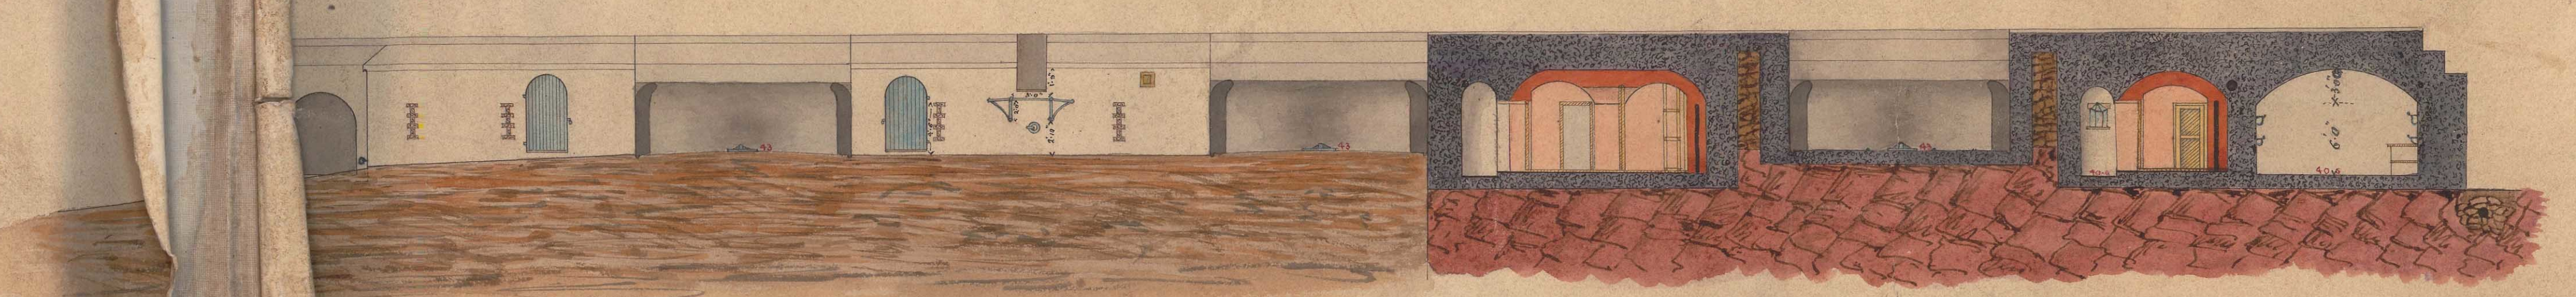

REFERENCE

DATE OF COMMENCEMENT

DATE OF COMPLETION October 7th 1877.

ESTIMATED COST

ACTUAL COST

MATERIALS Blue Gas Lime Concrete, Portland Cement Concrete, & Brickwork.

EXECUTED BY Contractors and Military Labor.



No. A 19

G. J. G. [Signature]

C/42